


2130 RSF
SCALE: 3/16" = 1'-0"



KEY PLAN:

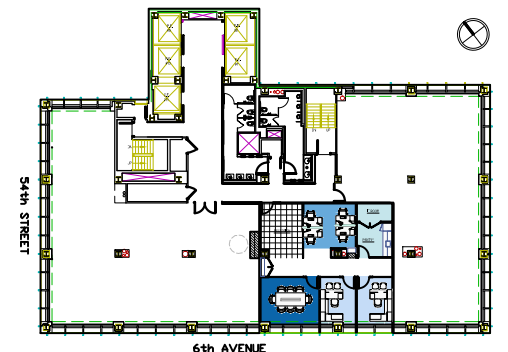

36th FLOOR- SUITE B AS BUILT

1330 Avenue of the Americas
Suite 2200A
New York, NY

PROJECT LOCATION	S:\Construction\Marketing\1330_AVA\SERIAL\2017_Marketing\
FILE NAME	PLOT DATE
1330_AVA_Marketing_Floor_011317.dwg (1/13/2017 - 5:03pm)	
DATE	Jan 13, 17
DRAWN BY	DBarone
	DRAWING NO.
	EX-1